


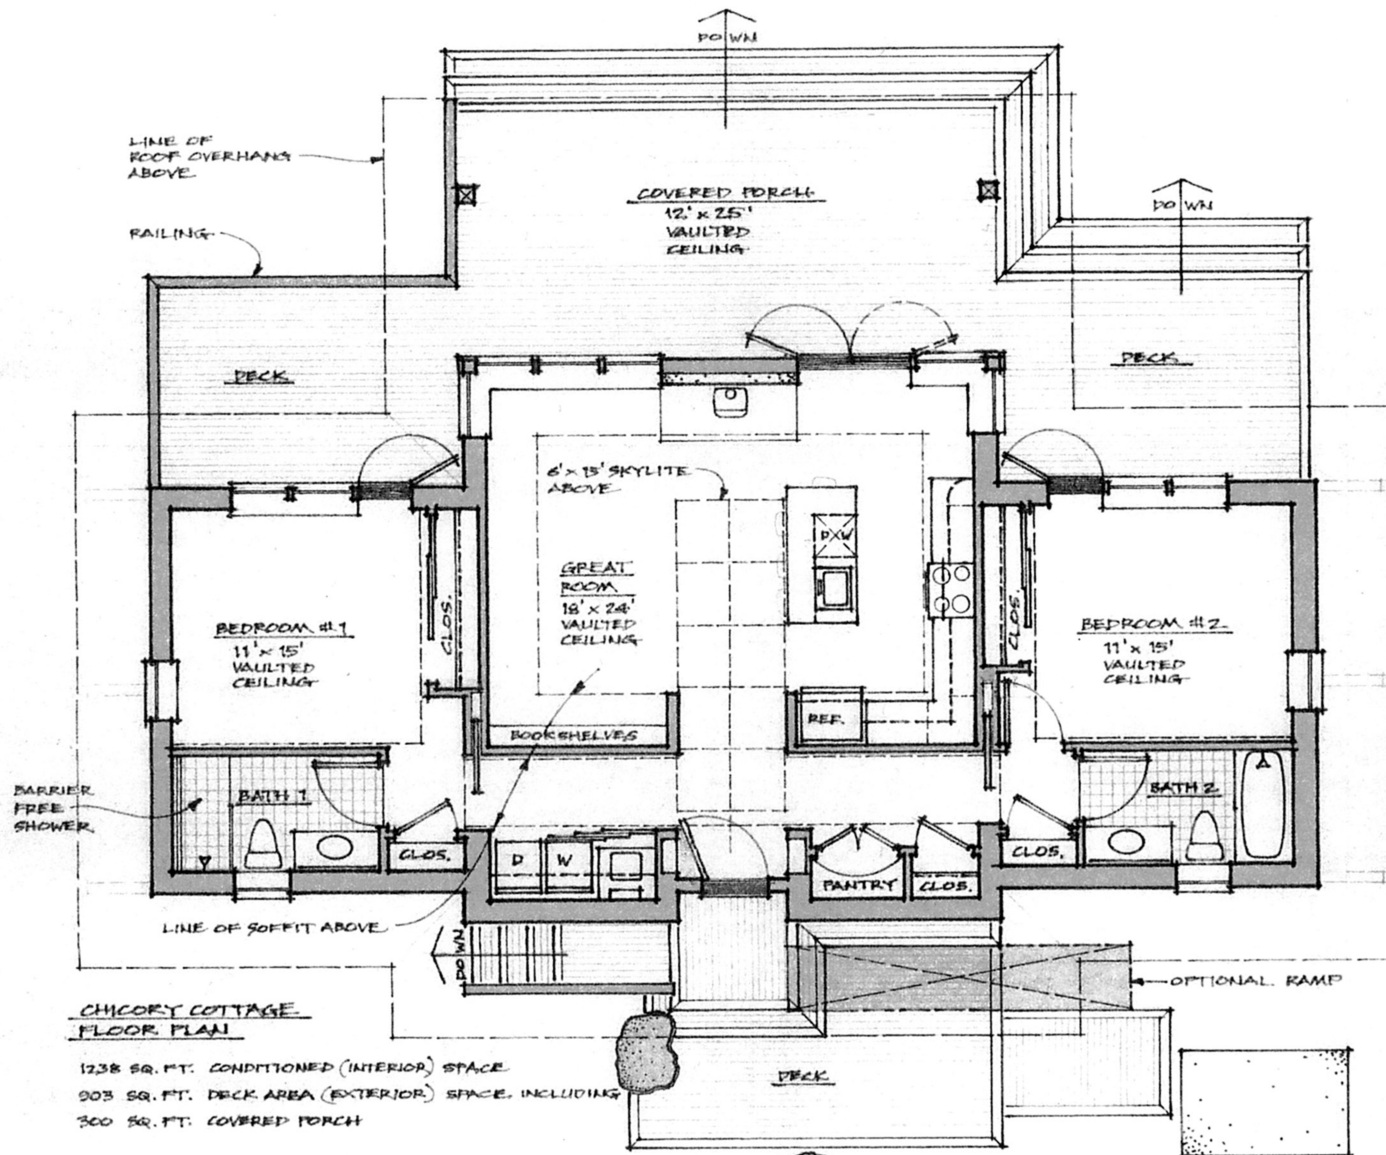

**CHICORY COTTAGE  
FLOOR PLAN**

1238 SQ. FT. CONDITIONED (INTERIOR) SPACE  
903 SQ. FT. DECK AREA (EXTERIOR) SPACE, INCLUDING  
300 SQ. FT. COVERED PORCH

VIRTUAL TOUR AT: [WWW.CHICORYCOTTAGE.NET](http://WWW.CHICORYCOTTAGE.NET)

CHICORY COTTAGE, 31 COLGAN CREEK ROAD EASTSOUND,

ORCAS ISLAND, WASHINGTON 98245

CHICORY COTTAGE

31 Colgan Creek Road  
Eastsound, WA 98245

ORCA'S ISLAND  
WASHINGTON

TPN: 271350013

DRAWN:  
MRH

DATE:  
4/5/24

AS-BUILT  
FLOOR PLAN

SHEET:

1

OF: 1

P.O. Box 133 • Eastsound, WA 98245  
(360) 376-4550 • FAX (360) 376-6550 • Site (360) 376-5784  
Email: [michalayworth@gmail.com](mailto:michalayworth@gmail.com)

*Handwritten signature*  
MICHAEL WORTH